

BARRY SWENSON BUILDER
A DIVISION OF GREEN VALLEY CORP.

777 North First Street
Fifth Floor
San Jose, Ca. 95112

777 North First Street Fifth Floor San Jose, Ca 95112 tel: (408) 287-0246 fax: (408) 998-1737

Consultant:

Revisions:


21 DECEMBER 2012
PLAN CHECK RESPONSE-1

COPYRIGHT C 2012

BARRY SWENSON BUILDER

ALNUT AVE. & CENTER ST.
SANTA CRUZ, CA.


 FIRE BARRIERS SHALL BE CONTINOUS THROUGH CONCEALED SPACES SUCH AS DROPPED CEILINGS AND SOFFITS. SECURITY GATE $\langle 6 \rangle$ BASEMENT GRILL SEE DTL. 12/A8.1 AND A6.1 FOR ELEVATION • FIRE BARRIER - SHALL BE PERMANENTLY IDENTIFIED WITH SIGNS OR STENCILING THAT INCLUDE THE FOLLOWING: 7 BASEMENT DECORATIVE GRILL SEE DTL. 14/A8.1 AND A6.1 FOR ELEVATION A. LOCATED IN ACCESSIBLE 8 BOLLARD - SEE DTL. 1/A8.1 SYMBOL LEGEND CONCEALED FLOOR, FLOOR-CEILING OR ATTIC SPACES
B. REPEATED AT INTERVALS NOT 9 4" WIDE, WHITE PAINTED PARKING LINE. EXIT SIGN, GRAPHICS, ILLUMINATIONS, POWER SOURCE & TACTILE EXCEEDING 30 FEET MEASURED EXIT SIGNAGE, TO COMPLY WITH CBC 1011.3 & POWER SUPPLY HORIZONTALLY ALONG THE WALL OR TO COMPLY W/ 1011.5.3 PARTITION 10 FLOOR DRAIN, RE: PLUMB. C. INCLUDE LETTERING NOT LESS F.E. ● F.E. FIRE EXTINGUISHER, SEMI-RECESSED AT INTERIOR WALLS, SEE 16/A8.4 THAN 0.5 IN IN HEIGHTSTATING, "FIRE (1) GARAGE CLEARNCE SIGN - SEE DTL. 10/A8.1 BARRIER - PROTECT ALL OPENINGS" OR SIMILAR. CBC 703.6 EMERGENCY EXIT LIGHT. SEE ELECTRICAL DRAWINGS (12) 42" GUARDRAIL SEE MECH. PLANS FOR DUCT CONNECTIONS, ETC. D.S. GALVANIZED SHEET METAL DOWNSPOUT & PAINTED (13) 6'-0" TALL ORNAMENTAL FENCE WALL TYPES TO BE 1—HR FIRE—RATED (4) 6-0" TALL ORNAMENTAL GATE TYPE 3 UNLESS NOTED OTHERWISE F.O.S. FACE OF STUD - SEE 3/A8.8 15 PLATFORM LIFT ALL WALLS CONTAINING DUCTS TO BE F.O.C. FACE OF CONCRETE INSULATED FOR SOUND 4" TALL CONC. HOUSEKEEPING PAD CENTER LINE 4" HIGH (MIN.) CURB DOOR TYPE, SEE DOOR SCHEDULE ON SHEET A6.1 WINDOW TYPE, SEE WINDOW SCHEDULE ON SHEET A6.2

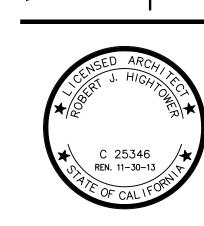

Date:
OCTOBER 23, 2012
Scale:
AS NOTED
Drawn by:
AG,AP,TC,YM
Job #:

A2.2

11-9149

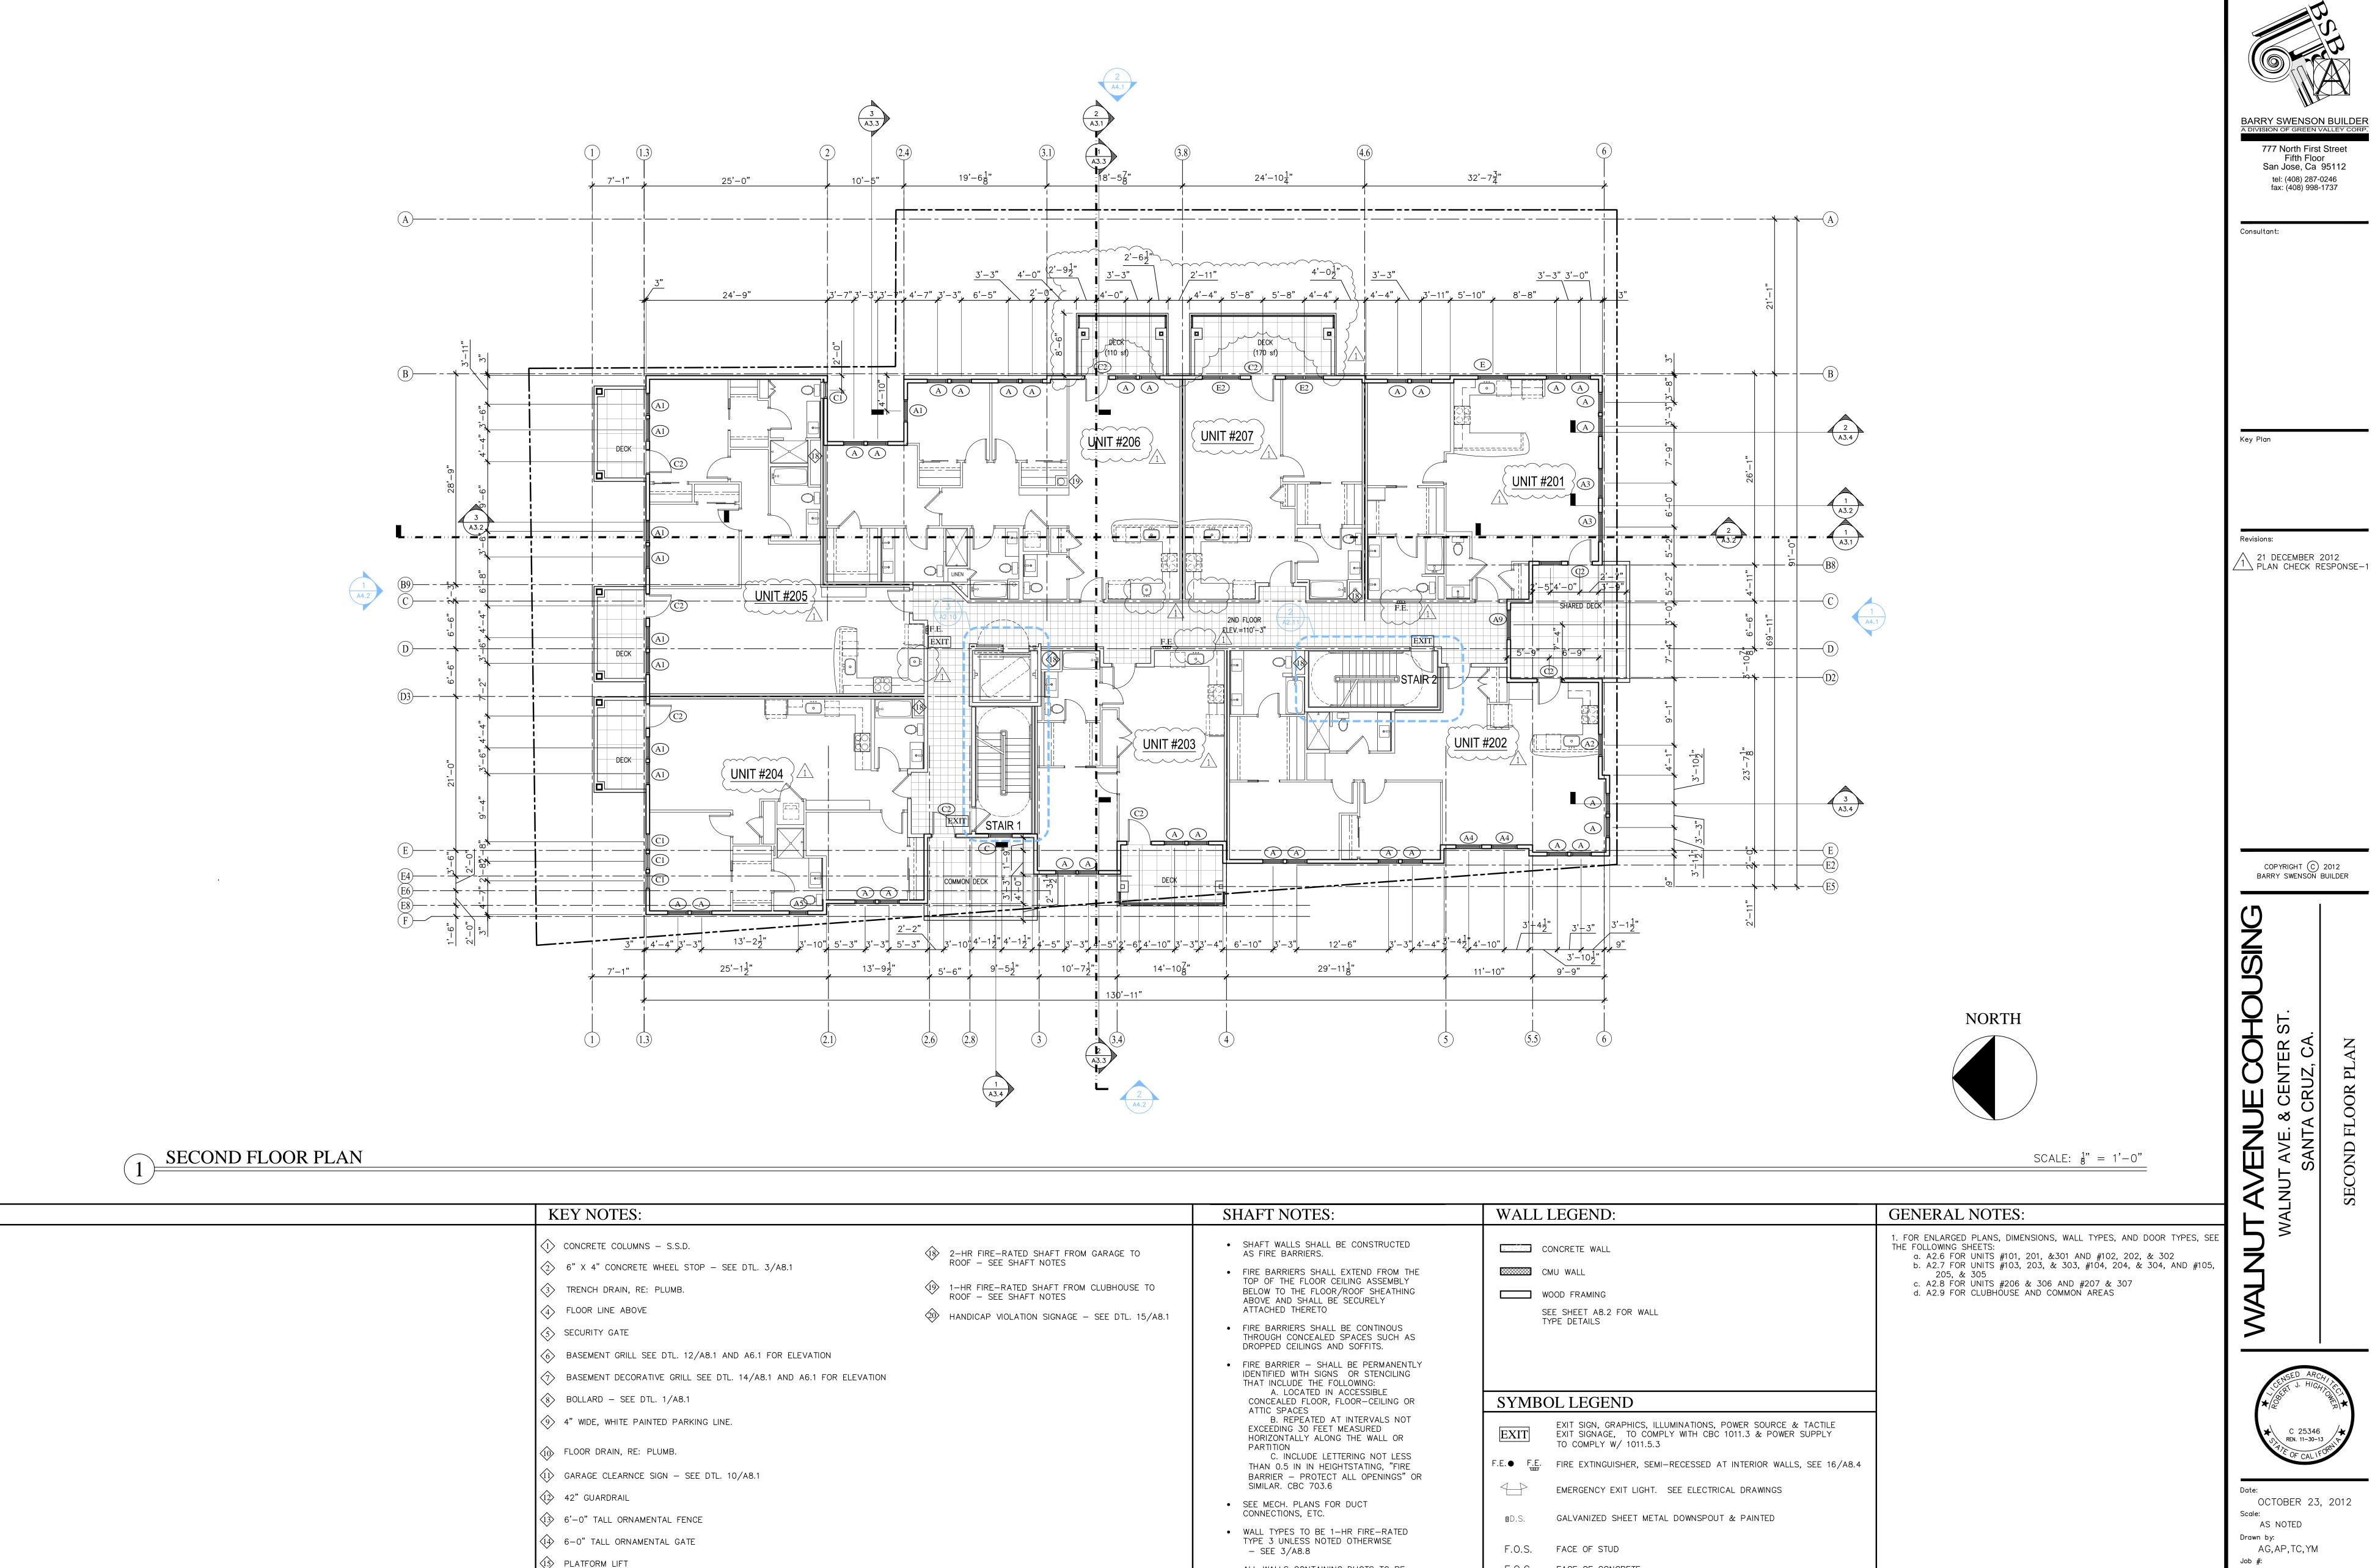

ALL WALLS CONTAINING DUCTS TO BE

INSULATED FOR SOUND

4" TALL CONC. HOUSEKEEPING PAD

⟨17⟩ 4" HIGH (MIN.) CURB

F.O.C. FACE OF CONCRETE

CENTER LINE

DOOR TYPE, SEE DOOR SCHEDULE ON SHEET A6.1


WINDOW TYPE, SEE WINDOW SCHEDULE ON SHEET A6.2

777 North First Street Fifth Floor San Jose, Ca 95112 tel: (408) 287-0246 fax: (408) 998-1737


COPYRIGHT (C) 2012 BARRY SWENSON BUILDER

★\ C 25346 /

OCTOBER 23, 2012 AS NOTED AG,AP,TC,YM Job #: 11-9149

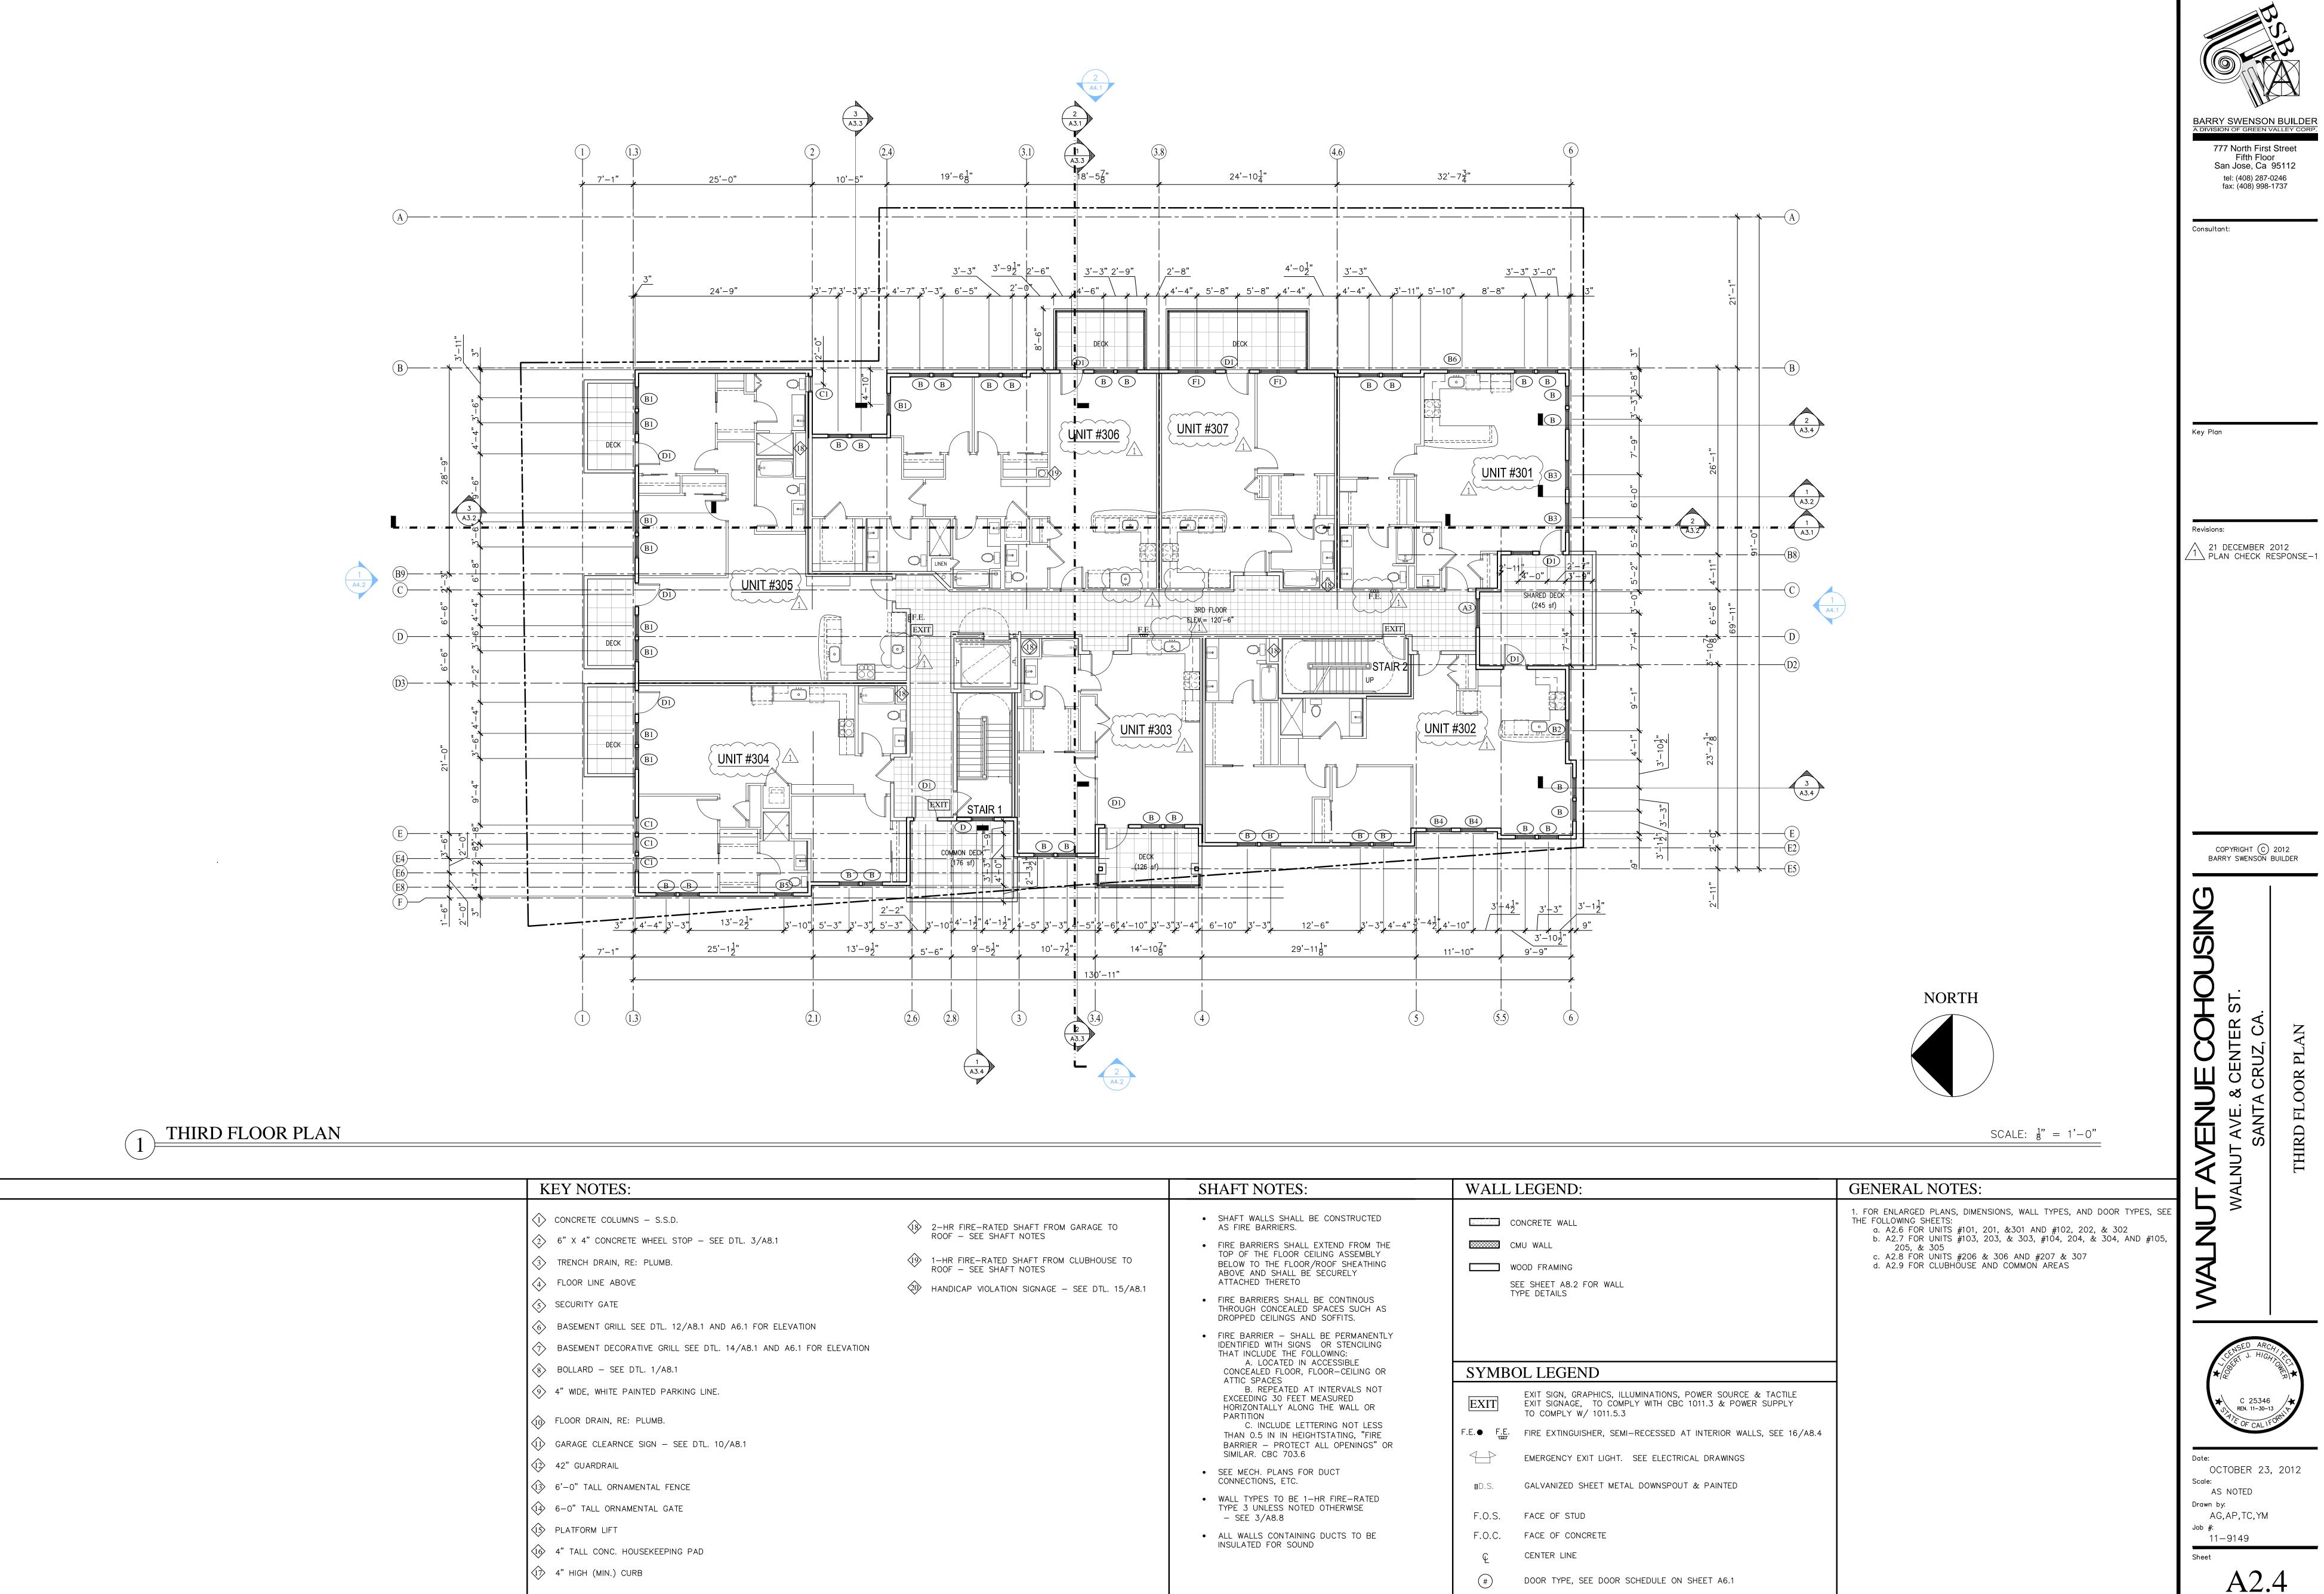

777 North First Street San Jose, Ca 95112 tel: (408) 287-0246 fax: (408) 998-1737

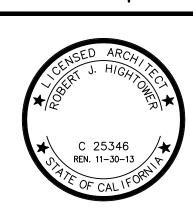

OCTOBER 23, 2012

WINDOW TYPE, SEE WINDOW SCHEDULE ON SHEET A6.2